


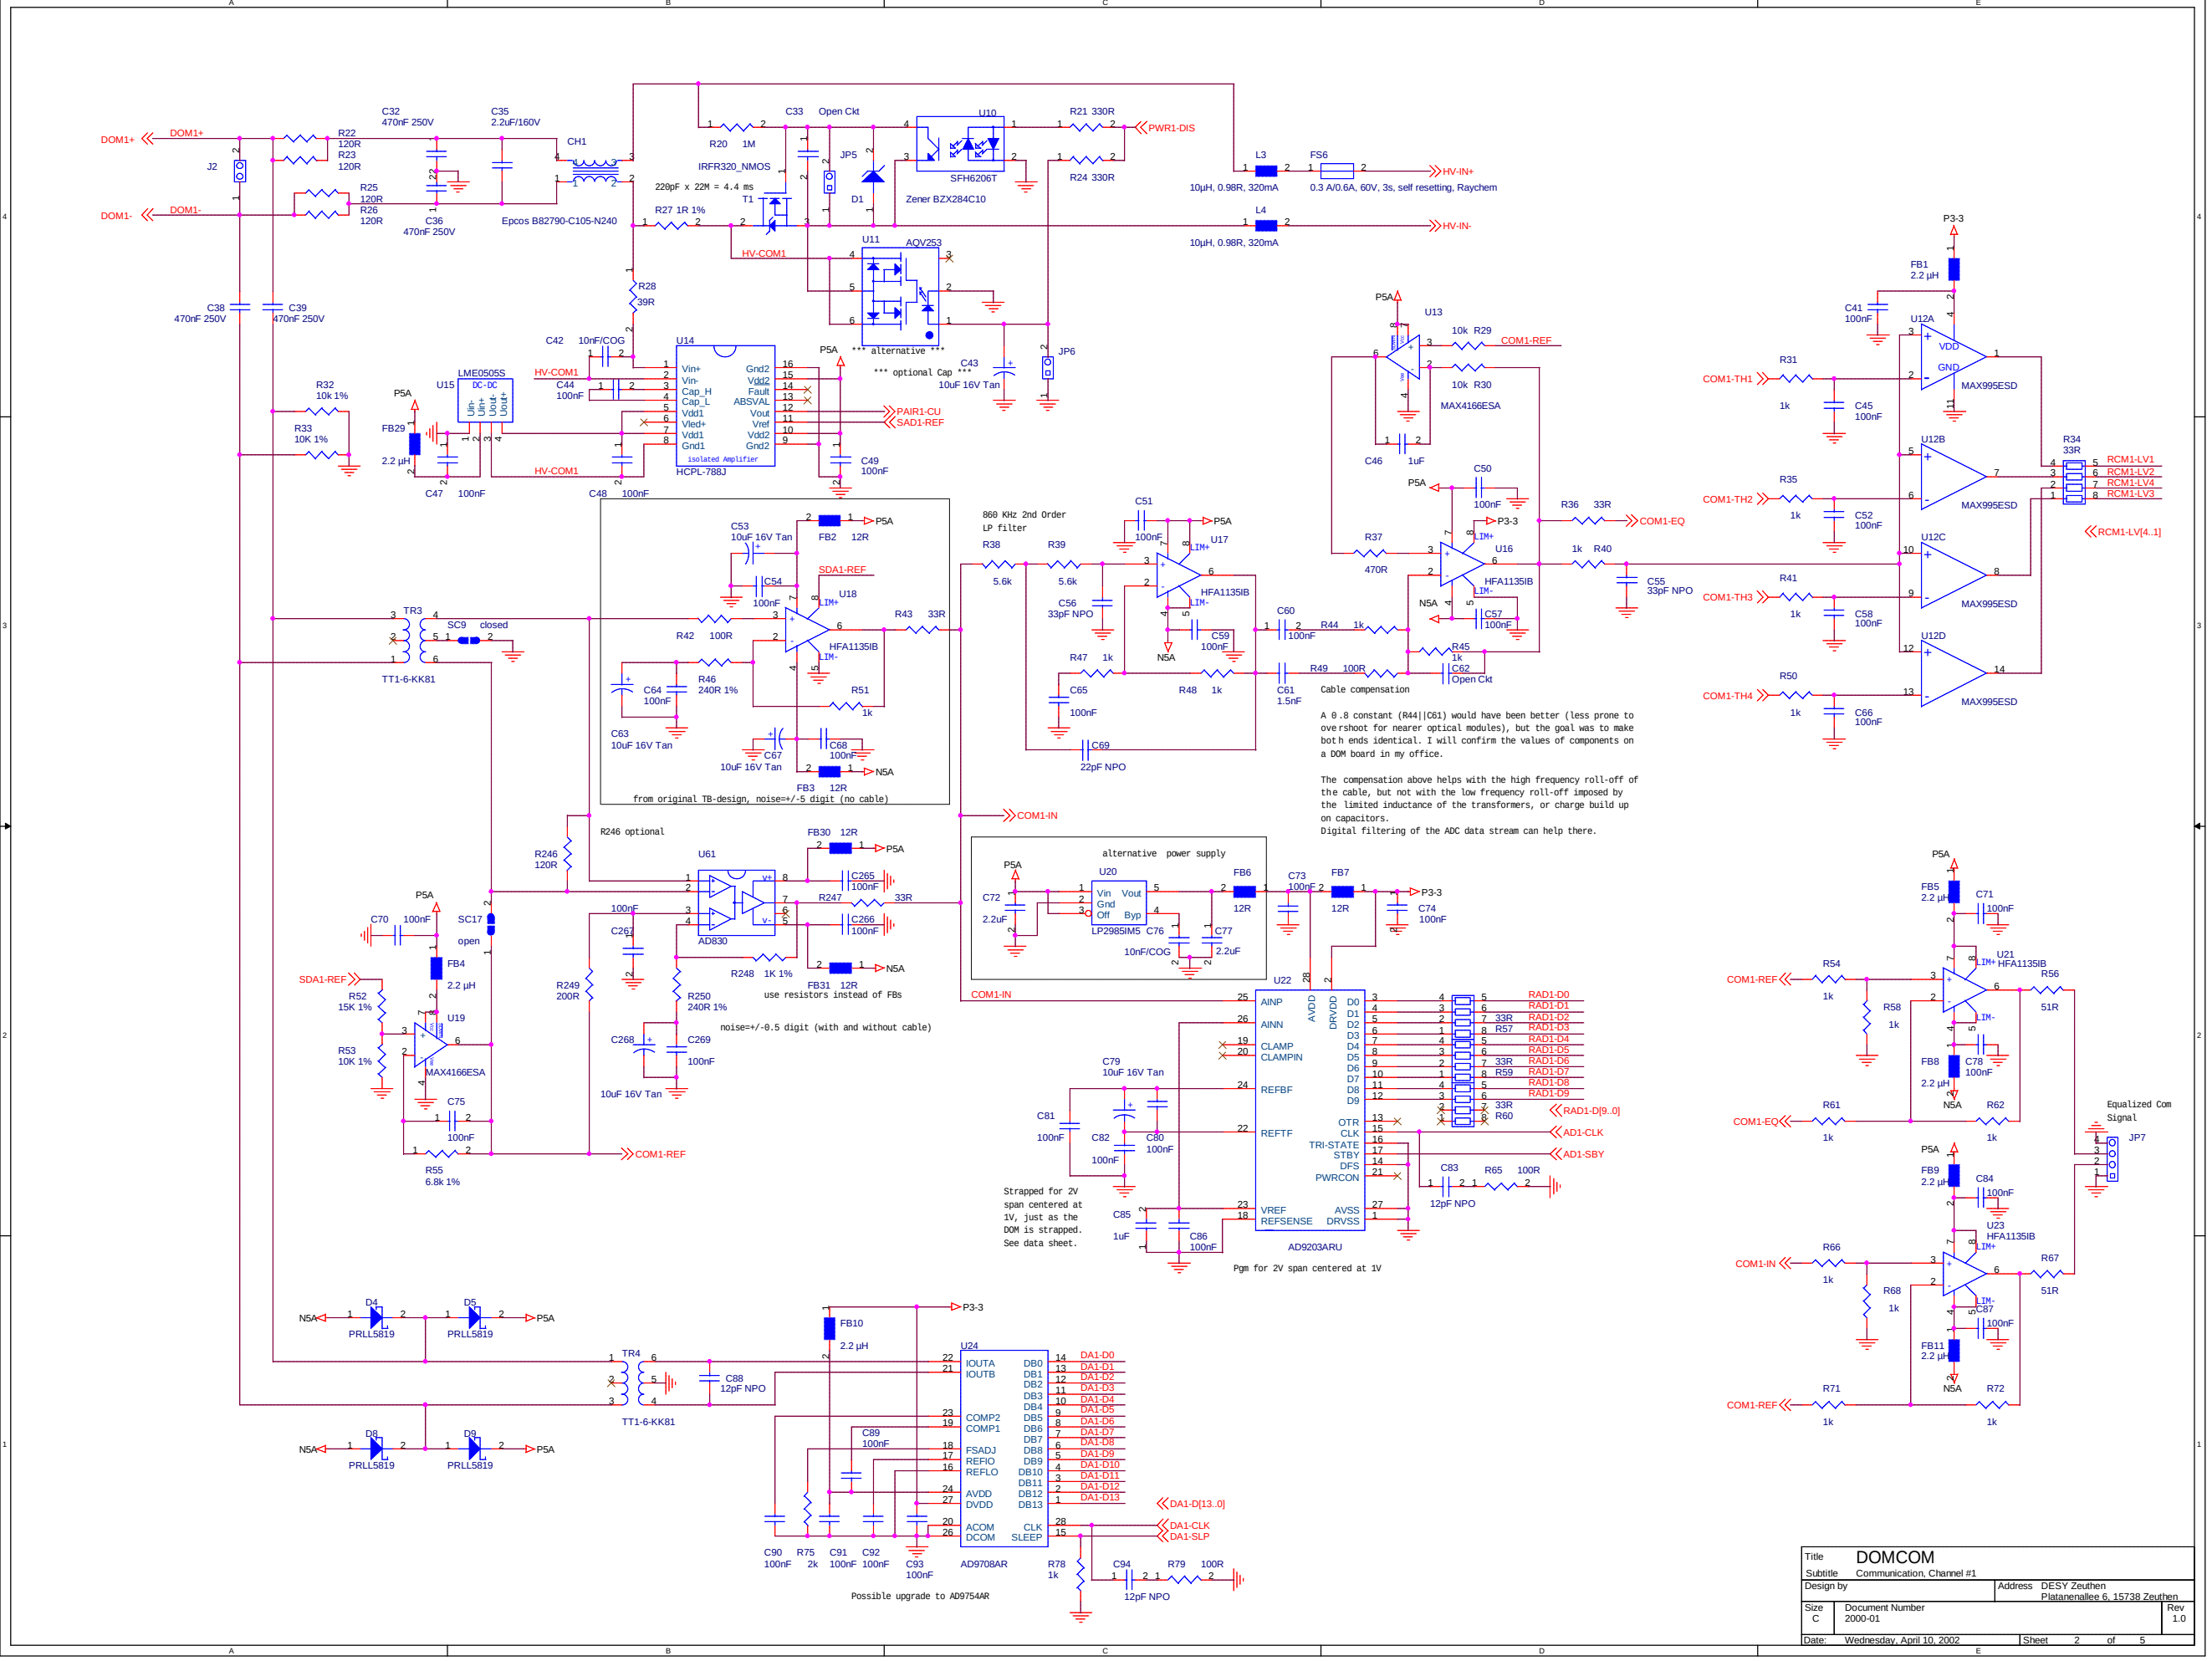


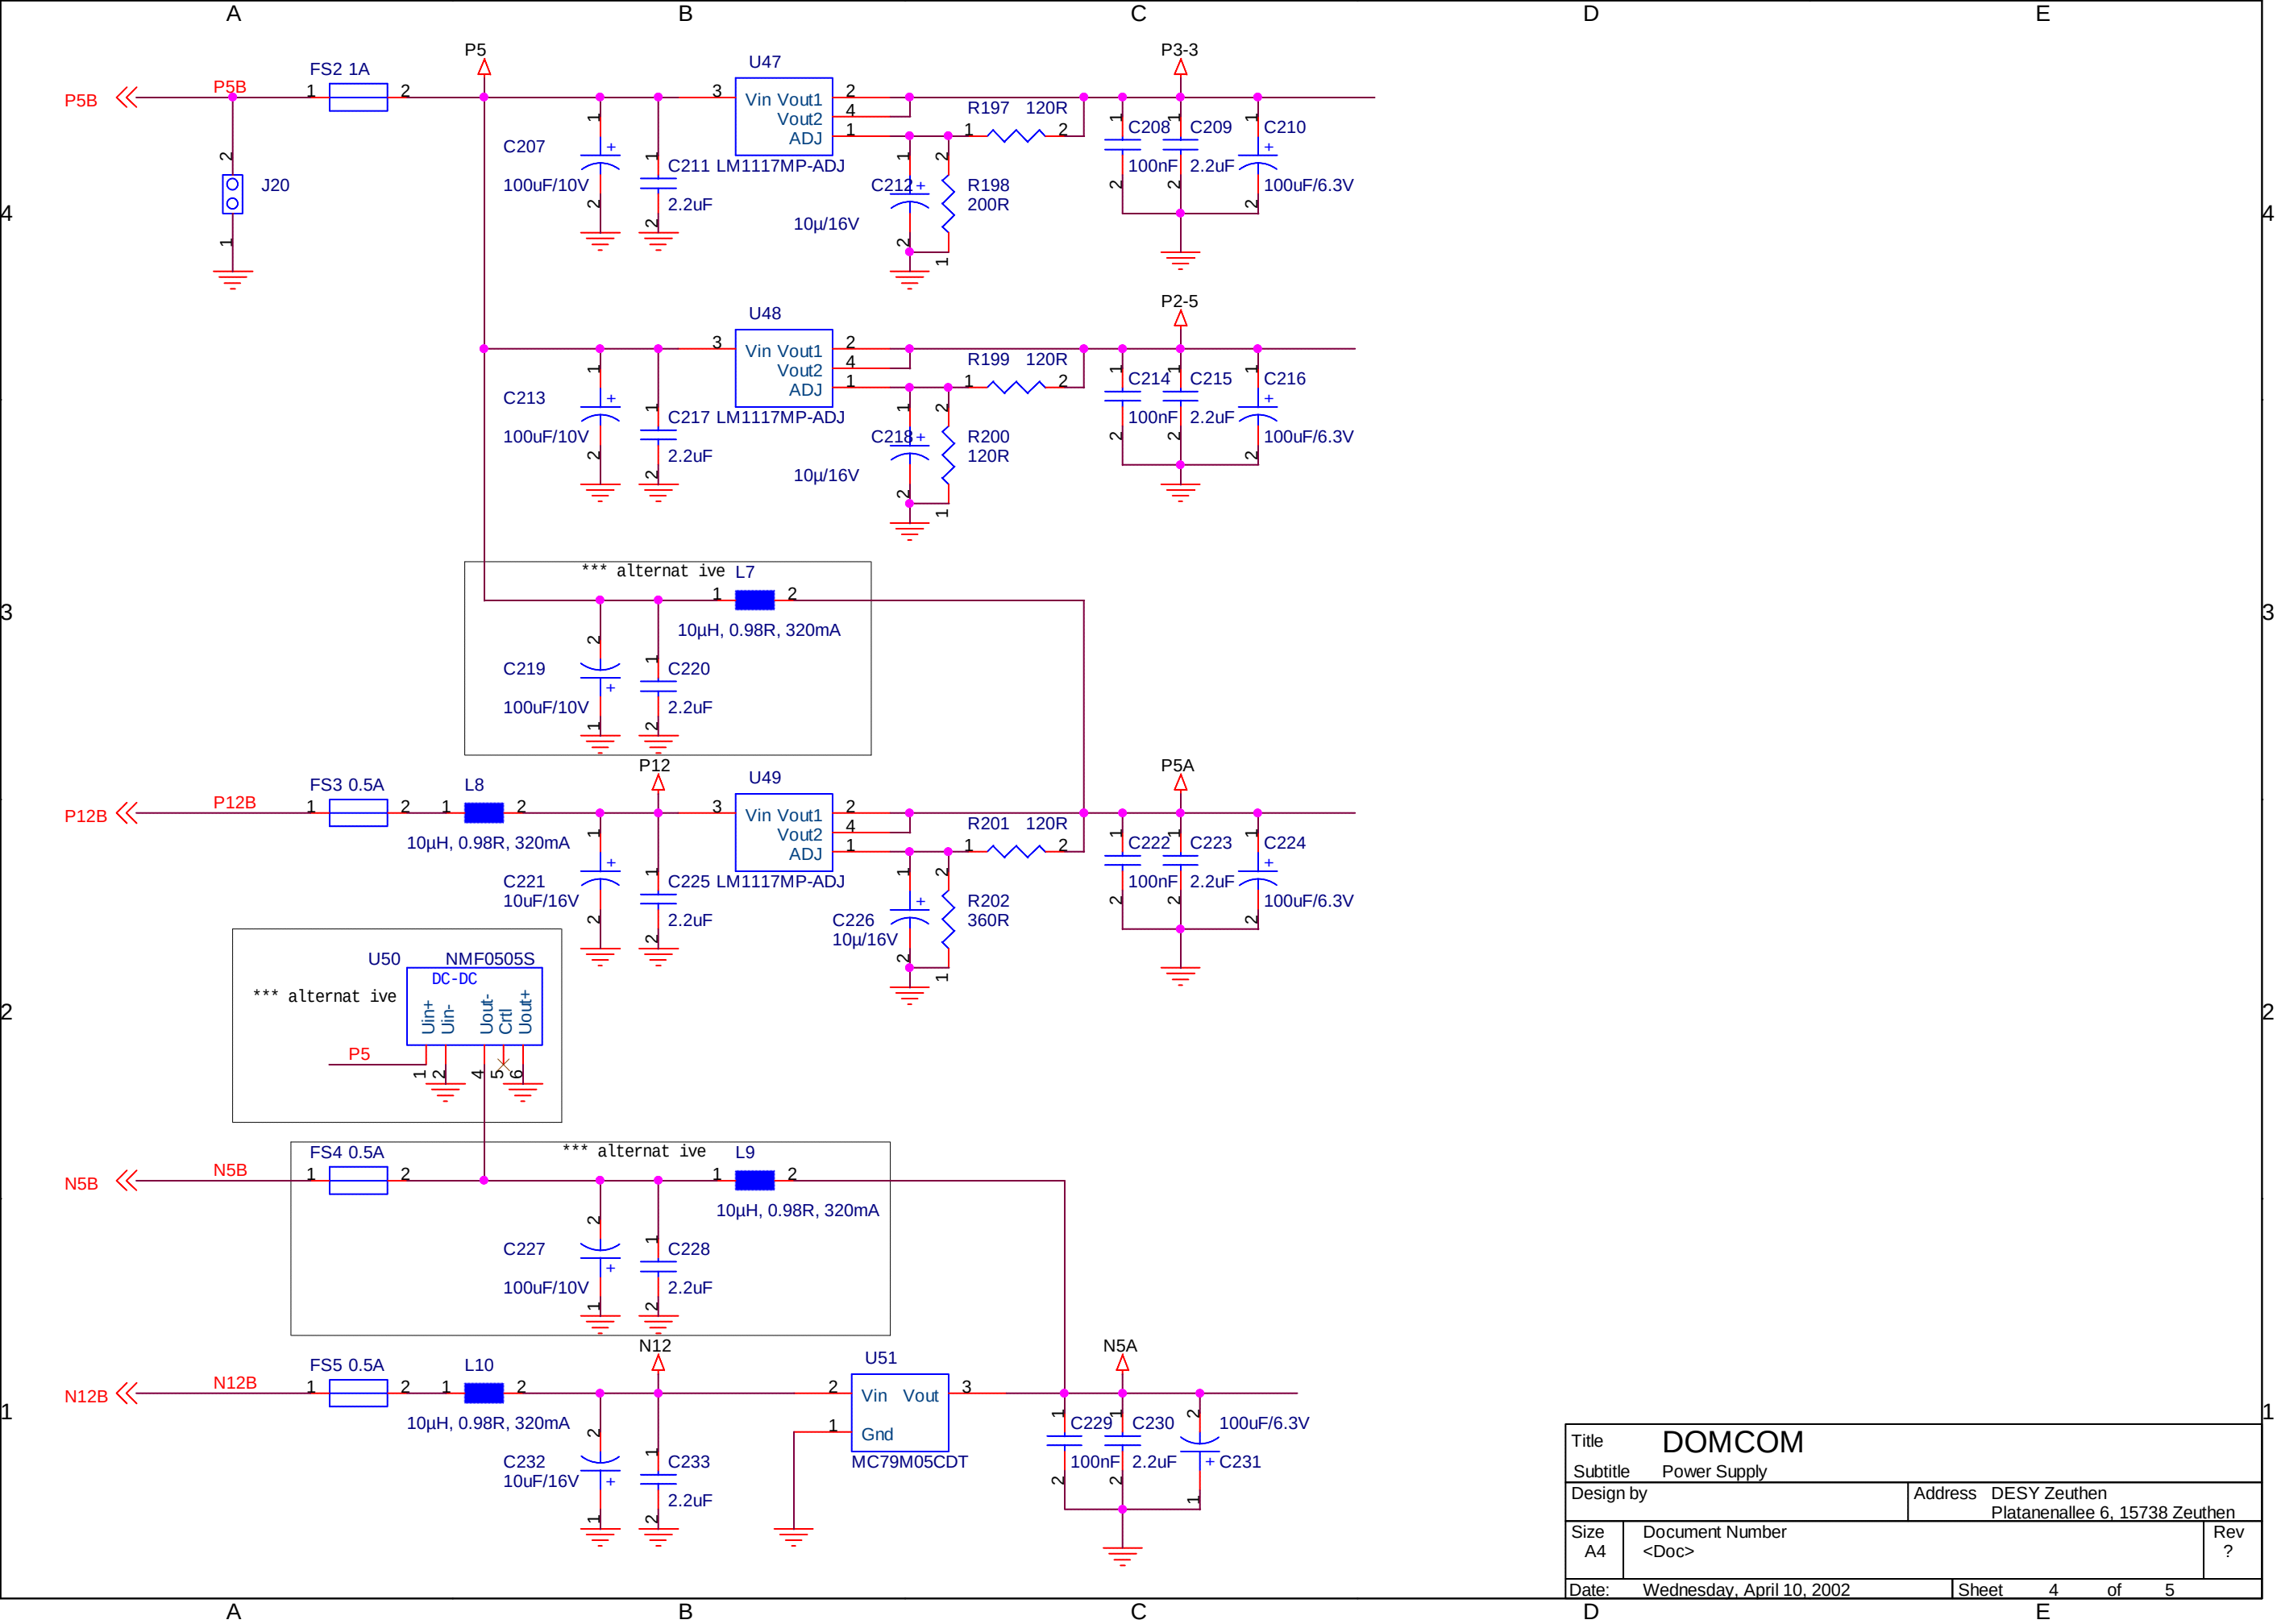

Title DOMCOM			
Subtitle Communication, Channel #1			
Design by		Address DESY Zeuthen Platanenallee 6, 15738 Zeuthen	
Size C	Document Number 2000-01	Rev 1.0	
Date: Wednesday, April 10, 2002		Sheet	2 of 5

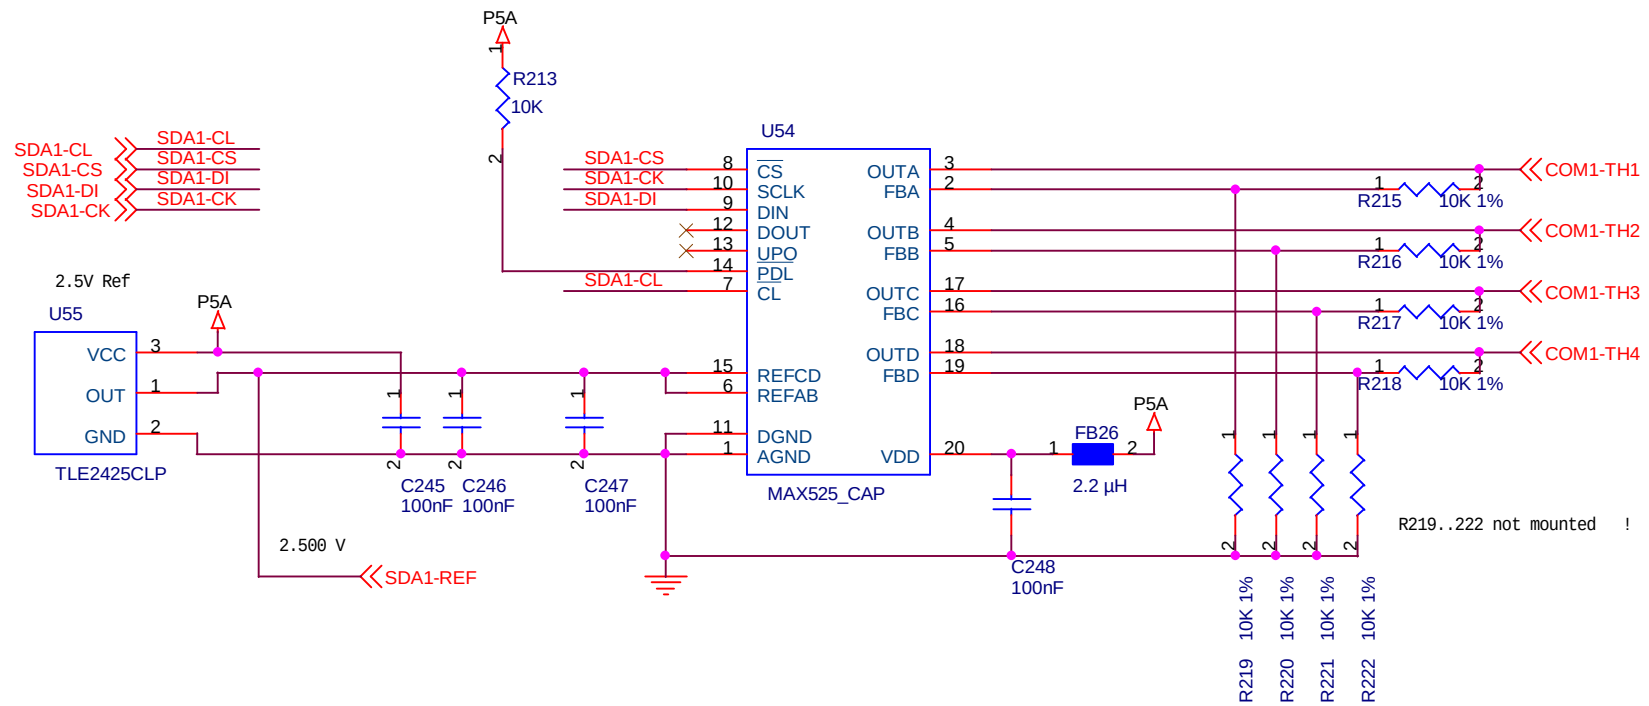

Title			DOMCOM	
Subtitle			Power Supply	
Design by			Address DESY Zeuthen Platanenallee 6, 15738 Zeuthen	
Size	Document Number			Rev
A4	<Doc>			?
Date:	Wednesday, April 10, 2002		Sheet	4 of 5

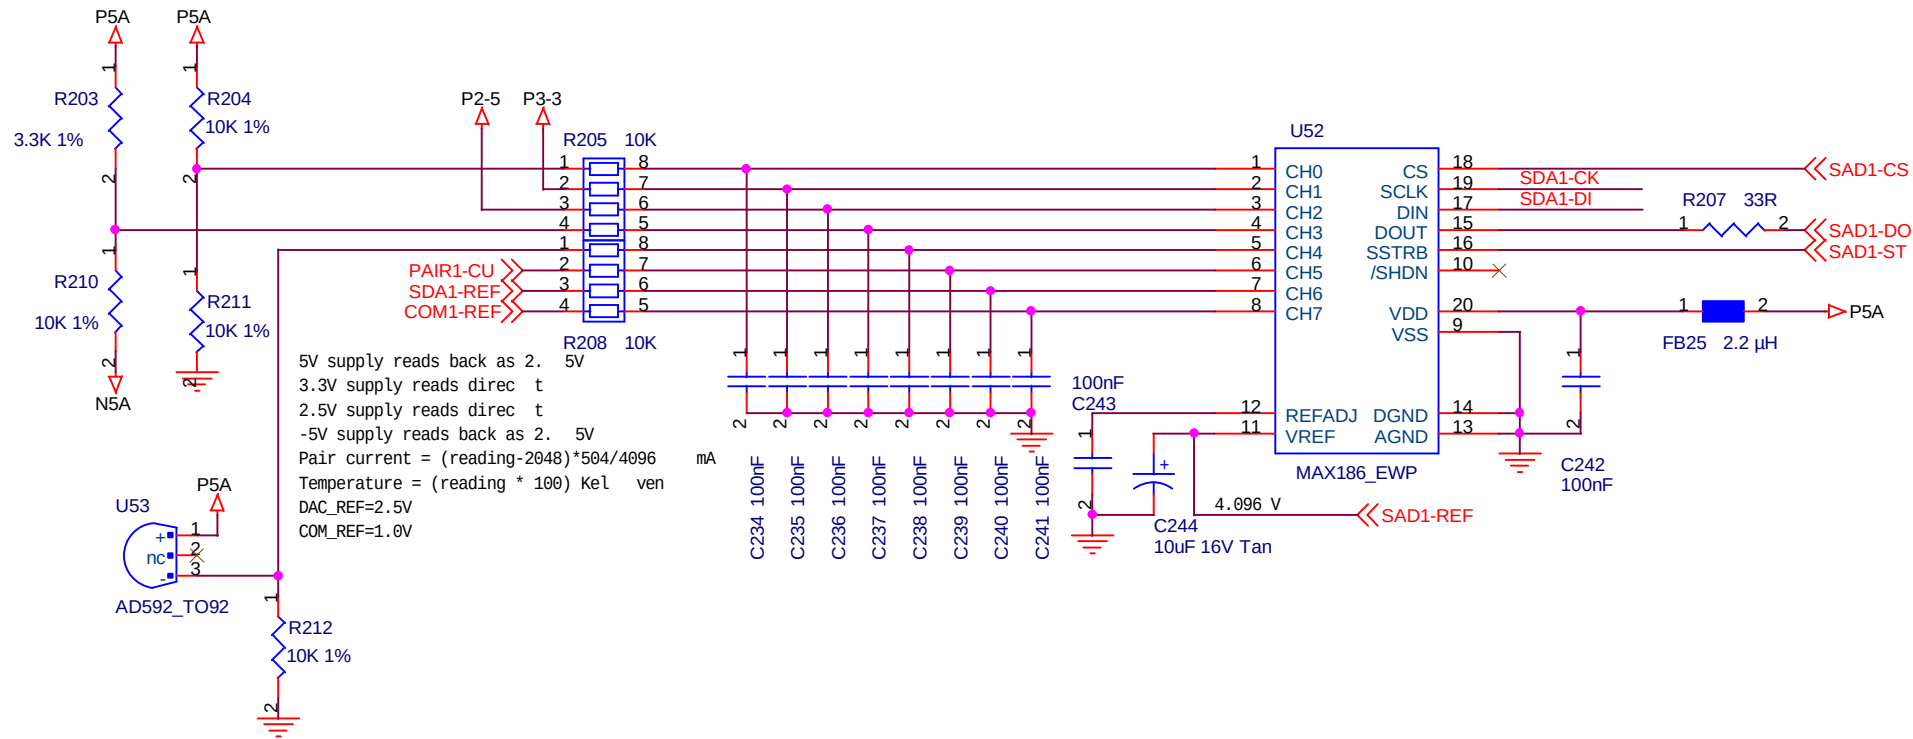

Title		DOMCOM		
Subtitle		SADC/SDAC, channel 1		
Design by		Address DESY Zeuthen Platanenallee 6, 15738 Zeuthen		
Size B	Document Number 2000-01	Rev 1.0		
Date:	Wednesday, April 10, 2002	Sheet	5 of 5	